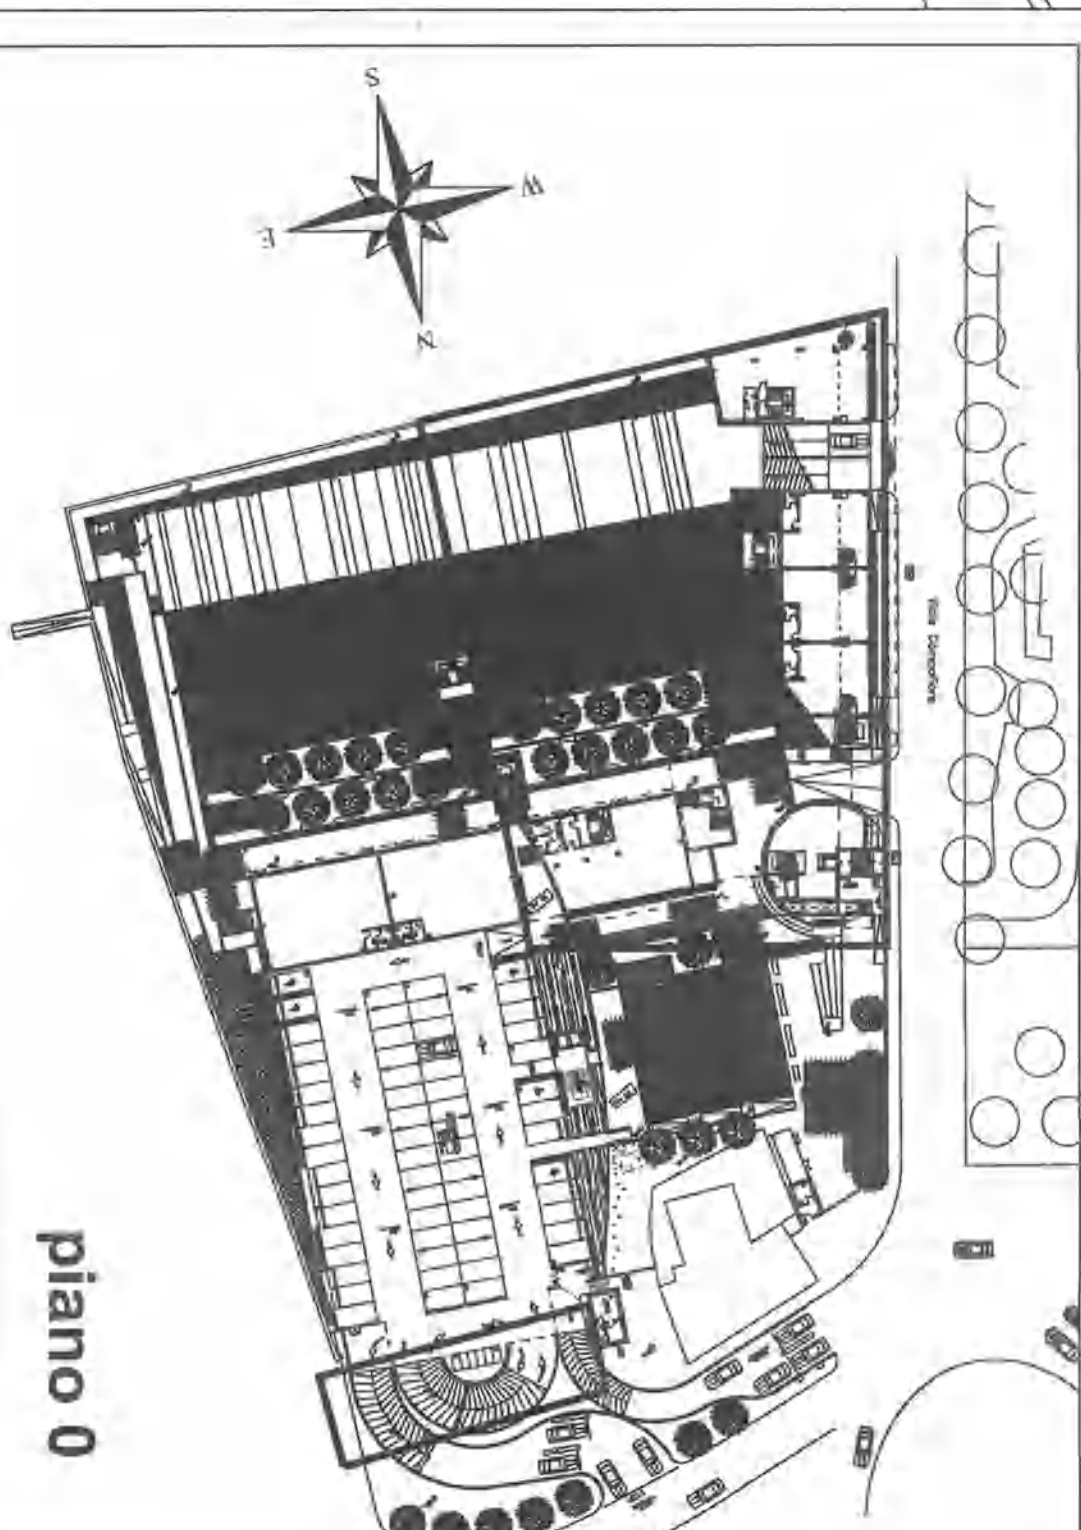
[illegible][illegible]